
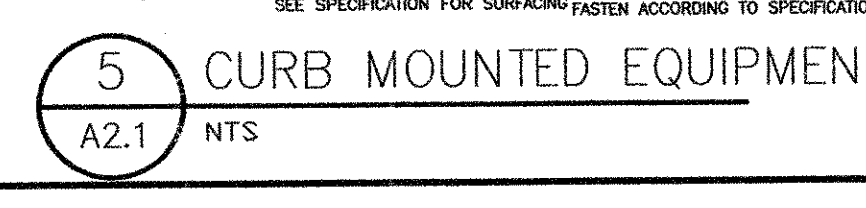
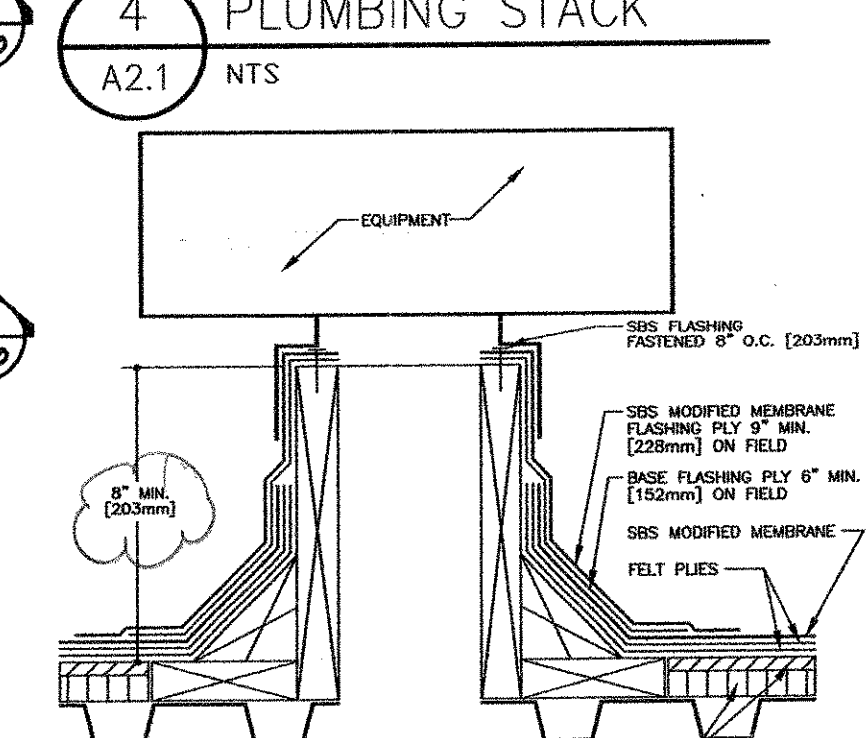
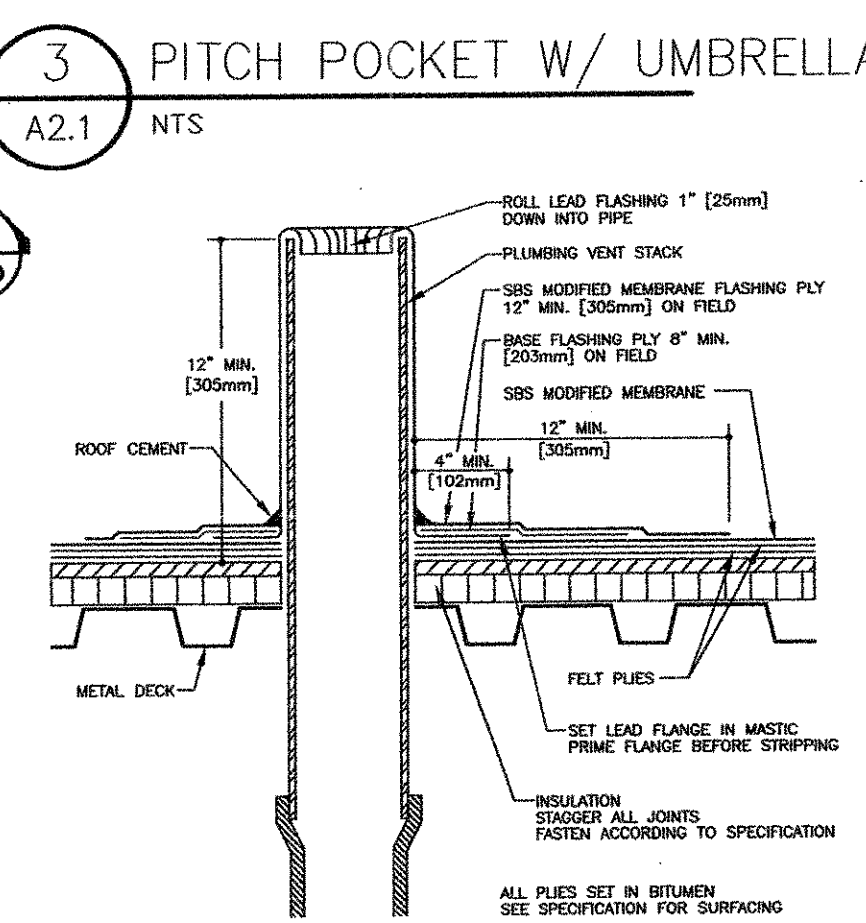
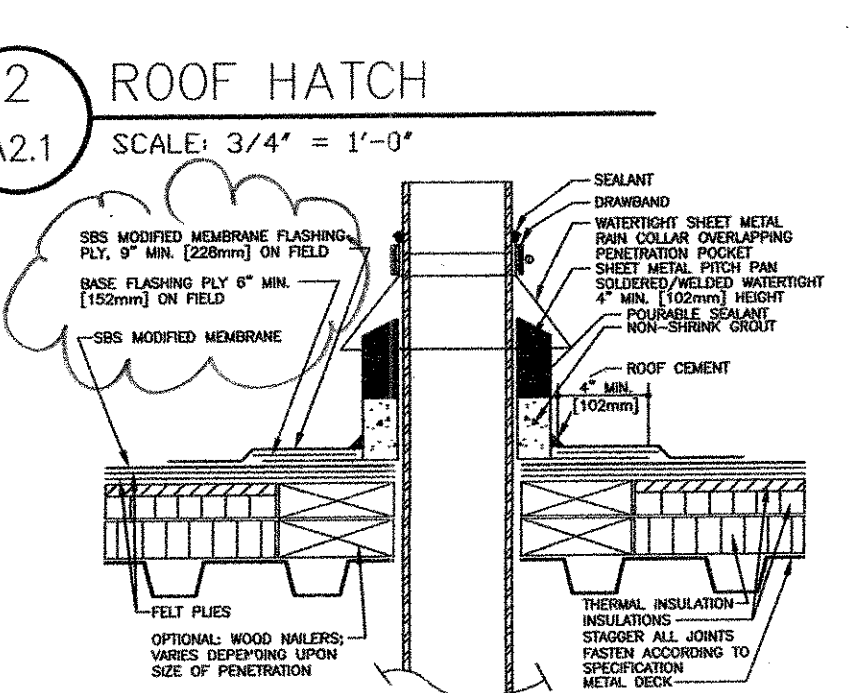
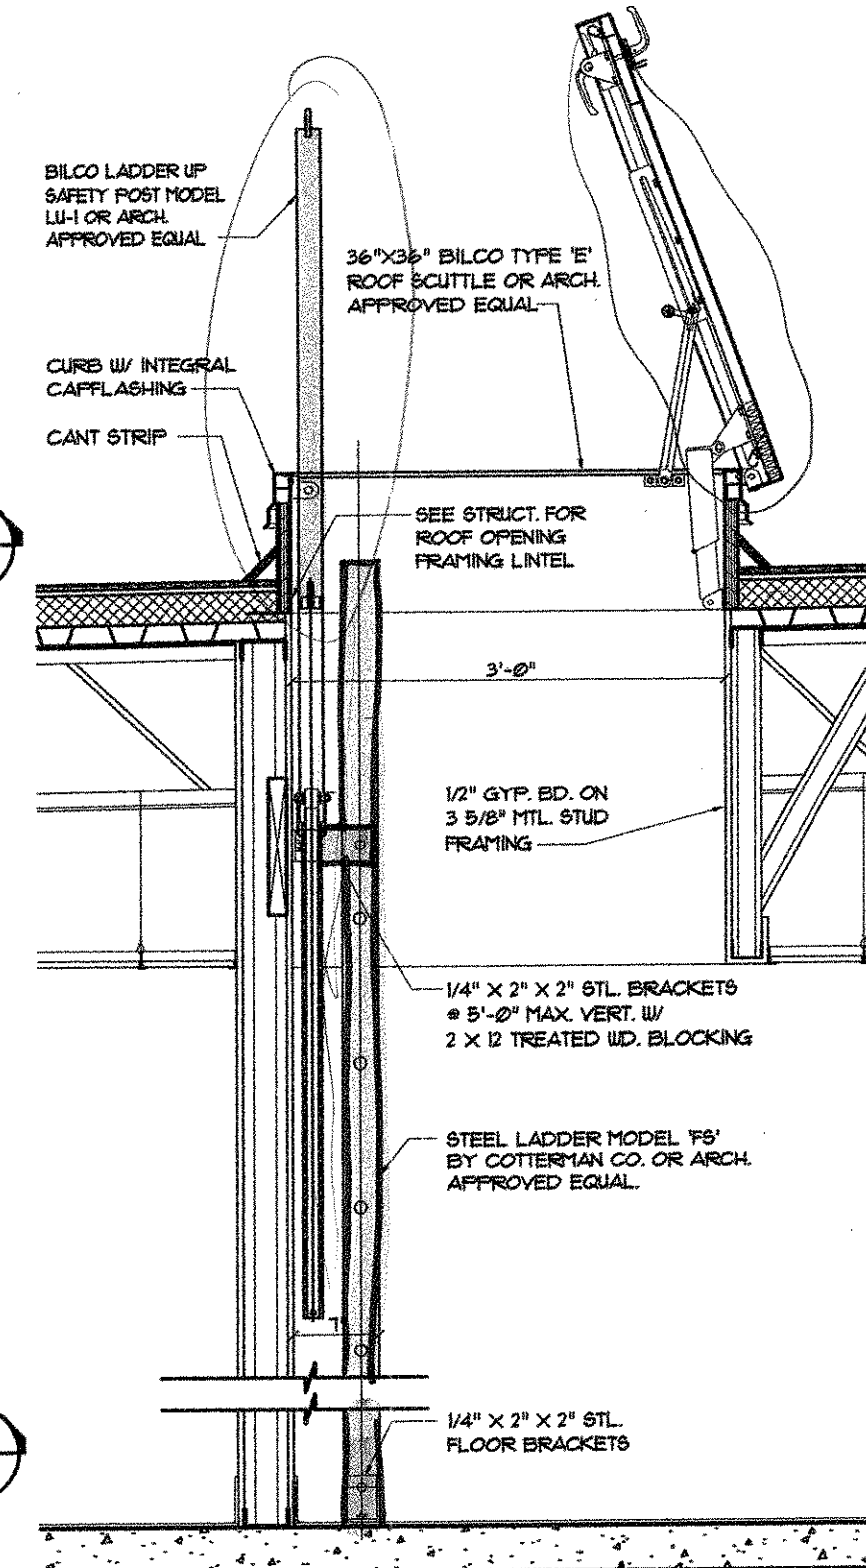


DATE	DESCRIPTION	BY
5/25/09	REVISIONS PER OWNER REVIEW/16C	DBS
	REVISIONS	

POPE/PARTNERS ARCHITECTS, INC.
 ARCHITECTS • PLANNERS • RECREATIONAL PLANNERS
 1176 GRIMES BRIDGE ROAD • SUITE 500 • ATLANTA, GA 30375
 TEL: (770) 645-0130 • FAX: (770) 645-0132

HAMPTON PARK PUBLIC LIBRARY
FORSYTH COUNTY, GEORGIA

DATE	FEB. 15, 2008
COMM. NO.	07003
DWN. CHK.	DBS SEP
SCALE	AS SHOWN
ROOF PLAN	
SHEET NUMBER	A2.1

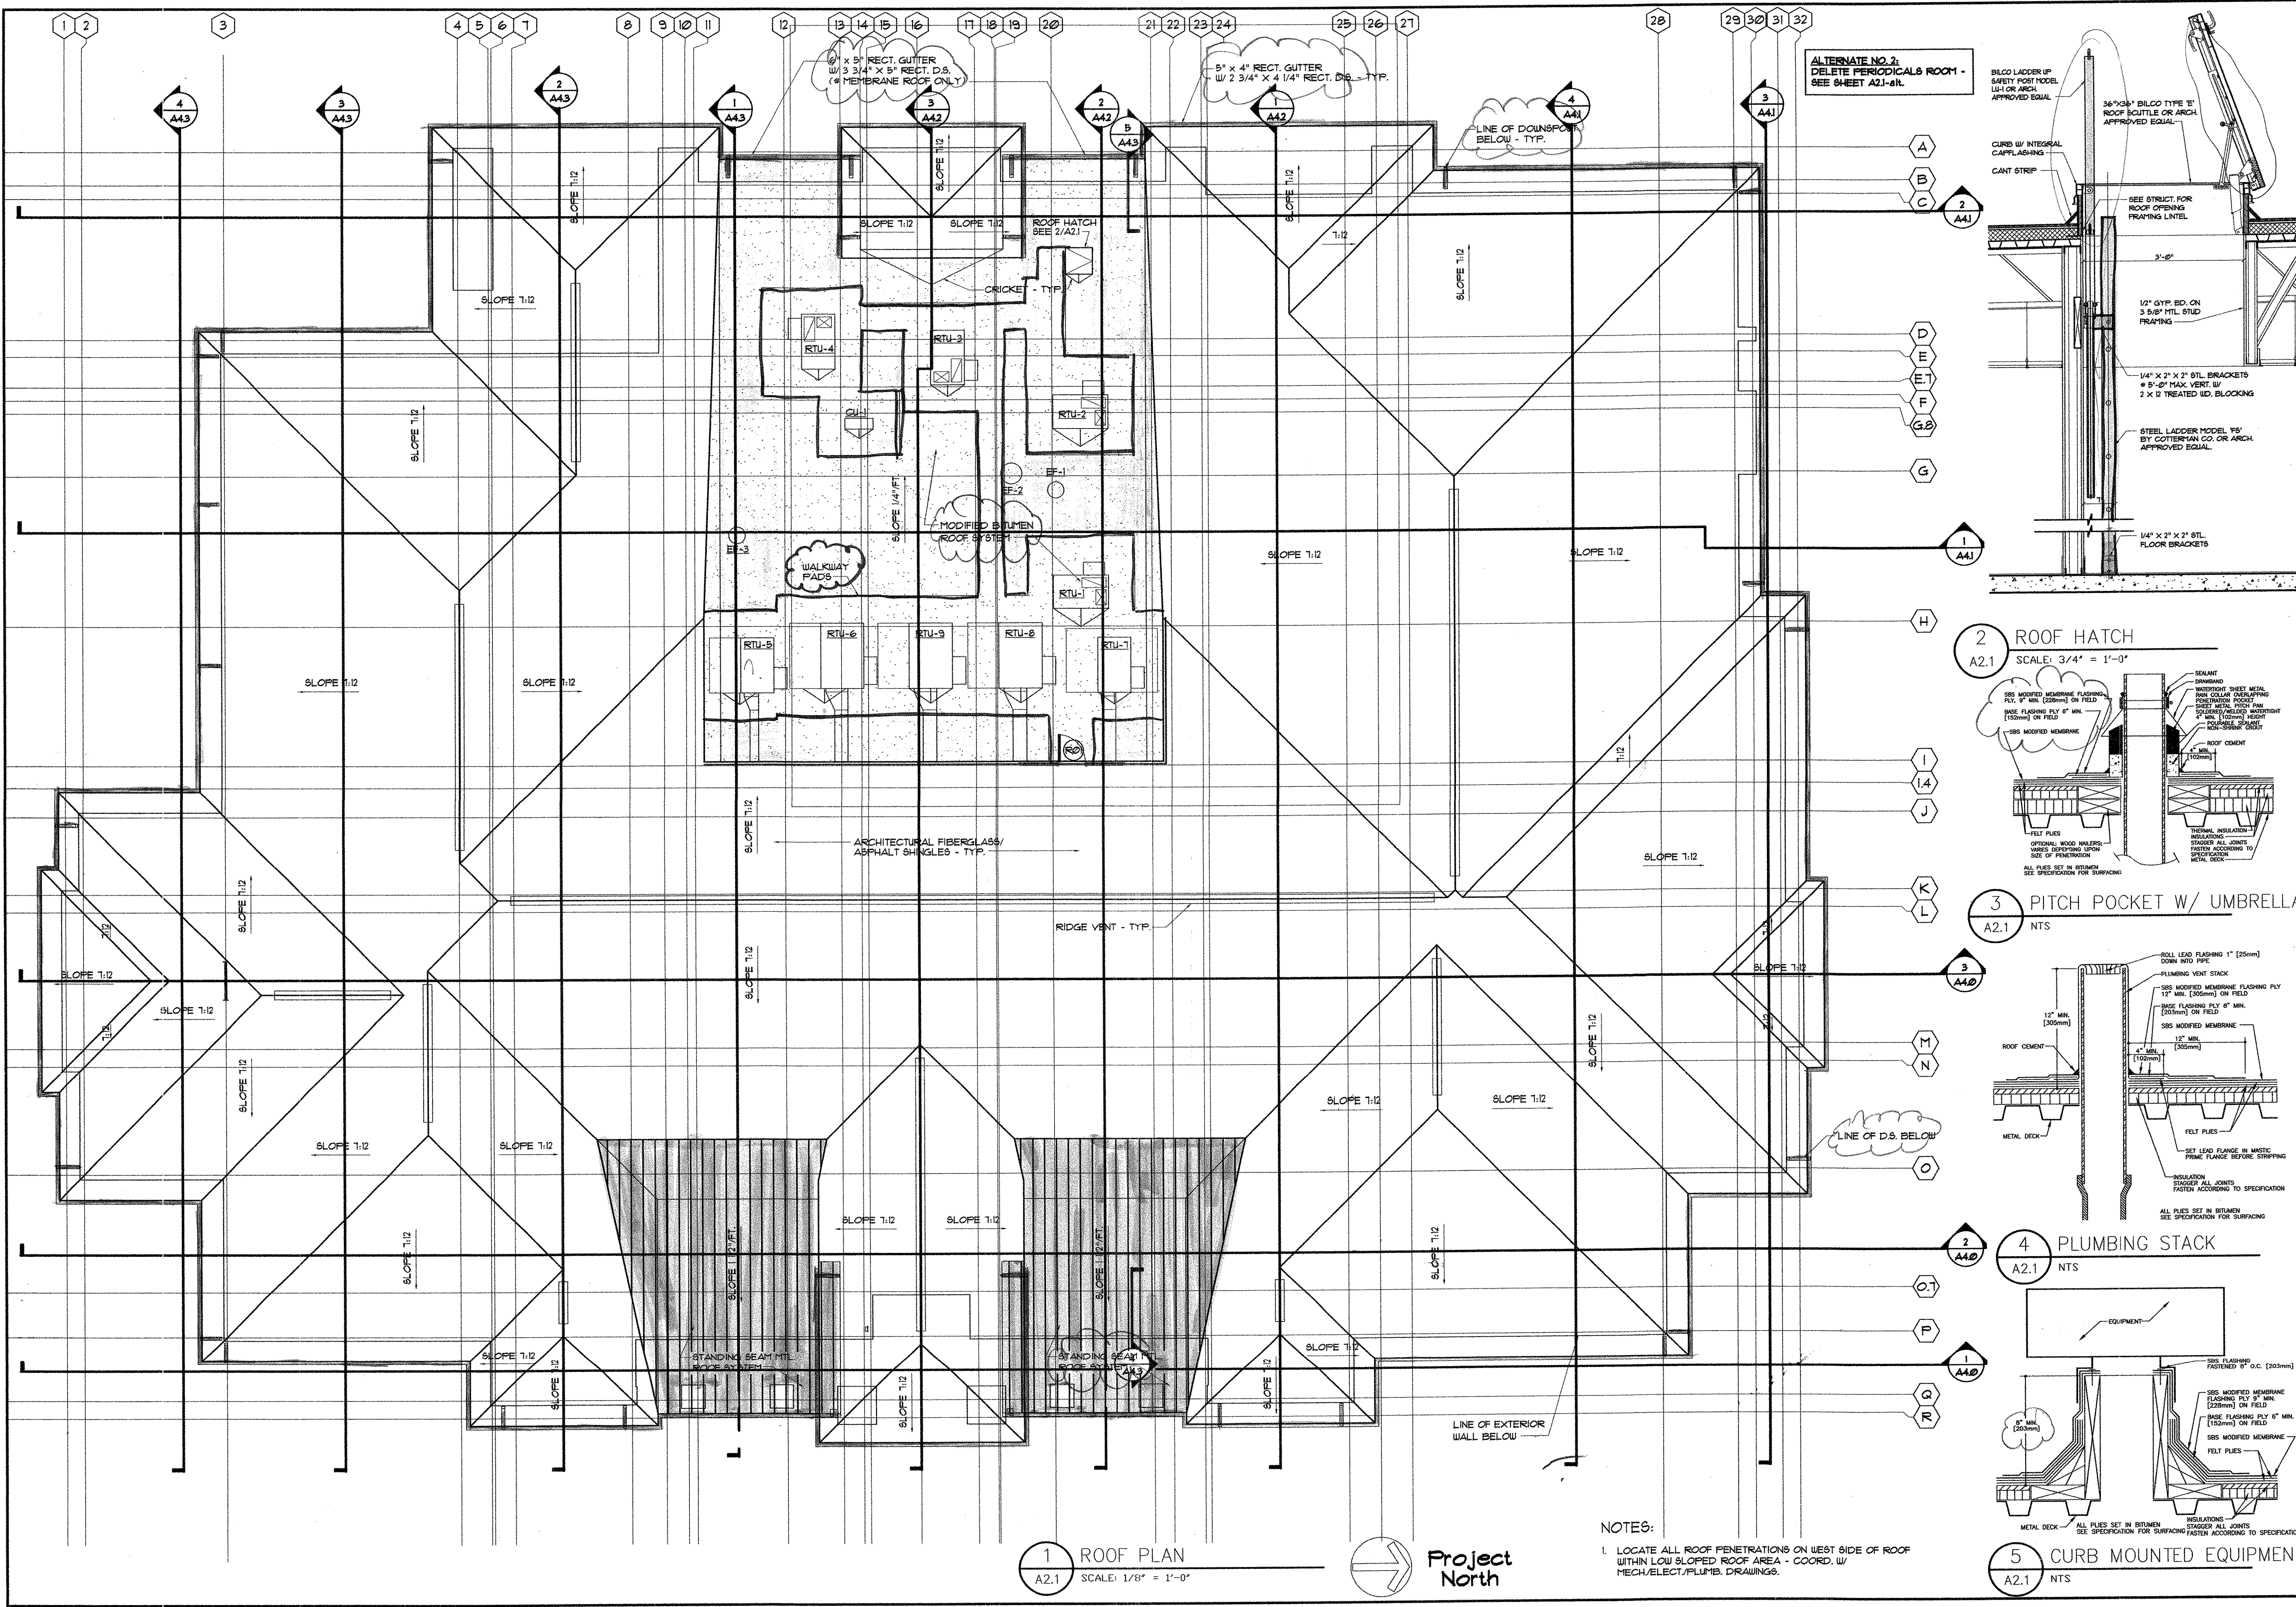

1 ROOF PLAN
 A2.1 SCALE: 1/8" = 1'-0"



NOTES:
 1. LOCATE ALL ROOF PENETRATIONS ON WEST SIDE OF ROOF WITHIN LOW SLOPED ROOF AREA - COORD. W/ MECH/ELECT./PLUMB. DRAWINGS.