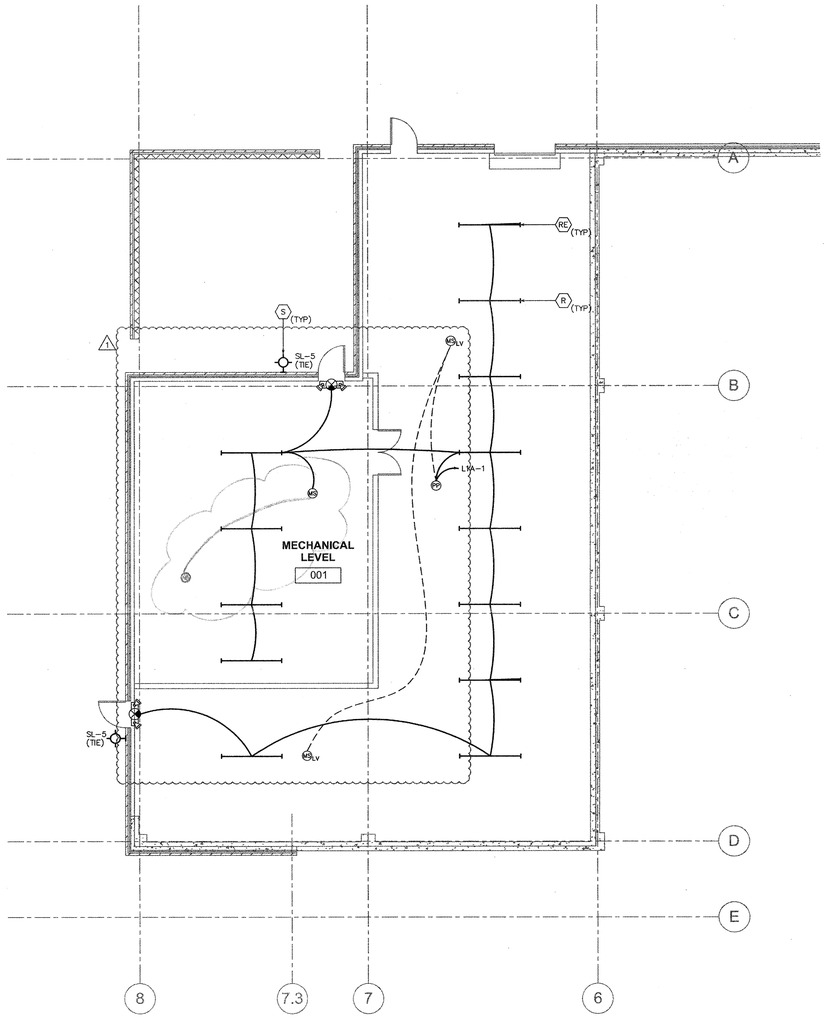

BASEMENT LEVEL LIGHTING PLAN

1/8"=1'-0" NORTH

CRAIG architecture
GAULDEN planning
DAVIS interiors

19 Washington Park
Greenville, SC 29601

P.O. Box 2527
Greenville, SC 29602

Phone (864) 242-0761
Fax (864) 233-2319
E-mail cgd@cgdarch.com

ASSOCIATE ARCHITECT

Professional Design Group, LLC
A PROFESSIONAL GROUP ASSOCIATES COMPANY
Architecture I Interior Design I Consulting
2000 RiverEdge Parkway, Suite 735, Atlanta GA 30328
Phone: 770.916.7660 Fax: 770.933.0692

COPYRIGHT © 2008 CRAIG GAULDEN & DAVIS, INC.
ALL RIGHTS RESERVED

THIS COPYRIGHTED DOCUMENT AND ALL INFORMATION CONTAINED HEREIN IS AN INSTRUMENT OF SERVICE AND SHALL NOT BE REPRODUCED, ALTERED, OR REUSED IN PART OR IN WHOLE WITHOUT PRIOR WRITTEN PERMISSION FROM THE ARCHITECT. THIS DRAWING IS THE EXCLUSIVE PROPERTY OF THE ARCHITECT AND MUST BE RETURNED UPON REQUEST.

GEORGIA REGISTERED PROFESSIONAL ENGINEER SCOTT MERIWETHER

CONSULTANT

PROMUS
518 Black Canyon Park
Canton, GA 30114
Phone: 404.518.4265

Scott Meriwether, P.E.
Georgia License #30780

FORSYTH COUNTY PUBLIC LIBRARY SYSTEM

POST ROAD LIBRARY

DATE	MARK	DESCRIPTION
03/27/13	1	REVISIONS

ISSUE:	CONSTRUCTION DOCUMENTS
DATE:	01/24/2012
PROJECT NO:	09066
DRAWN BY:	DPF
CHECKED BY:	SDM

BASEMENT LEVEL LIGHTING PLAN

E201